


# Work Order ID 129276

**\*129276\***

Page 1

Friday, January 30, 2015 2:02:03 PM

Item ID: D3183-5 Accept **\*N900040100\*** Setup Start **\*NS1\***  
 Revision ID: Stop **\*NS2\***  
 Item Name: Bearing  
 Start Date: 1/30/15 Start Qty: 100.00 **\*100\*** Cust Item ID:  
 Required Date: 2/02/15 Req'd Qty: 100.00 **\*100\*** Customer:  
 Reference:

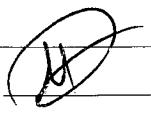Approvals: Process Plan:  Date: 1-1-30 Tooling: Date: Run Start **\*NR1\***  
 QC: Date: SPC (Y/N): Date: Stop **\*NR2\***

| Sequence ID/<br>Work Center ID | Operation<br>Description | Set Up/<br>Run Hours | Tool ID | Tool # | Plan<br>Code | Accept<br>Qty | Reject<br>Qty | Reject<br>Number | Insp.<br>Stamp |
|--------------------------------|--------------------------|----------------------|---------|--------|--------------|---------------|---------------|------------------|----------------|
| Draw Nbr                       | Revision Nbr             |                      |         |        |              |               |               |                  |                |
| D3183                          | Rev C1                   |                      |         |        |              |               |               |                  |                |

100 PURCHASING 0.00  
**\*100\***  
 Purchasing Memo 0.00  
 Purchasing Issue P/O: 27293 Bearing as per Dwg D3183 Single row, deep groove, Conrad type, shielded Possible Supplier: NSK P/N 6800ZZ Certificate of conformity note is required  
 CX 1501/30 100

110 Receive & Inspect for Damage & Mat'l Certs 0.00  
**\*110\***  
 Packaging Memo 0.00  
 Packaging Ensure certificate of conformity is attached  
 100X 8015-02-2

120 QC6- Inspect dimensions to drawing 0.00  
**\*120\***  
 QC Memo 0.00  
 Quality Control  
 DAS 38 9-89  
 100  
 FEB 02 2015

DQA: \_\_\_\_\_ Date: \_\_\_\_\_



## WORK ORDER NON-CONFORMANCE / UPDATE

QA Closed: \_\_\_\_\_ Date: \_\_\_\_\_

Work Order update only ☐

|                                                              |   |   |                                      |                                    |                                    |                                      |                                    |                                    |                                            |                                  |                                        |                                    |                                              |                                |                                    |                                    |                                   |  |
|--------------------------------------------------------------|---|---|--------------------------------------|------------------------------------|------------------------------------|--------------------------------------|------------------------------------|------------------------------------|--------------------------------------------|----------------------------------|----------------------------------------|------------------------------------|----------------------------------------------|--------------------------------|------------------------------------|------------------------------------|-----------------------------------|--|
| Work Order: _____<br><br>Part No. _____<br><br>NCR No. _____ | <b>DISPOSITION</b><br><br>Rework <input type="checkbox"/><br>Scrap <input type="checkbox"/><br>Use-as-is <input type="checkbox"/><br>Suspected Unapproved <input type="checkbox"/> | <b>AGAINST DEPARTMENT/PROCESS</b><br><br><table style="width: 100%;"> <tr> <td>Skid-tube <input type="checkbox"/></td> <td>Crosstube <input type="checkbox"/></td> <td>Water Jet <input type="checkbox"/></td> <td>Engineering <input type="checkbox"/></td> </tr> <tr> <td>Machining <input type="checkbox"/></td> <td>Small Fab <input type="checkbox"/></td> <td>Prod. Eng. Coord. <input type="checkbox"/></td> <td>Quality <input type="checkbox"/></td> </tr> <tr> <td>Thermoforming <input type="checkbox"/></td> <td>Finishing <input type="checkbox"/></td> <td>Rec/Store/Packaging <input type="checkbox"/></td> <td>Other <input type="checkbox"/></td> </tr> <tr> <td>Large Fab <input type="checkbox"/></td> <td>Composite <input type="checkbox"/></td> <td>Supplier <input type="checkbox"/></td> <td></td> </tr>





| Root Cause    | Date | Step | Qty | Description of work order update or non-conformance | Initial Chief Eng | Action Description | Sign & Date | Verification | QC Inspector |
|---------------|------|------|-----|-----------------------------------------------------|-------------------|--------------------|-------------|--------------|--------------|
| Design        |      |      |     |                                                     |                   |                    |             |              |              |
| Doc/Data      |      |      |     |                                                     |                   |                    |             |              |              |
| Equip/Tooling |      |      |     |                                                     |                   |                    |             |              |              |
| Handling/Pre  |      |      |     |                                                     |                   |                    |             |              |              |
| Material      |      |      |     |                                                     |                   |                    |             |              |              |
| Operator      |      |      |     |                                                     |                   |                    |             |              |              |
| Offset/Setup  |      |      |     |                                                     |                   |                    |             |              |              |
| Process       |      |      |     |                                                     |                   |                    |             |              |              |
| Supplier      |      |      |     |                                                     |                   |                    |             |              |              |
| Training      |      |      |     |                                                     |                   |                    |             |              |              |
| Transport     |      |      |     |                                                     |                   |                    |             |              |              |
| Unapproved    |      |      |     |                                                     |                   |                    |             |              |              |

### FAULT CATEGORY

|   |   |   |   |
|---|---|---|---|
| <b>Landing Gear</b><br><input type="checkbox"/> Bending<br><input type="checkbox"/> Centre Not Concentric<br><input type="checkbox"/> Cracks<br><input type="checkbox"/> Crimp/Kink/Ripple/Wave<br><input type="checkbox"/> Cuffs<br><input type="checkbox"/> Crushing<br><input type="checkbox"/> Heat Treat<br><input type="checkbox"/> Inspection Strip in Tube<br><input type="checkbox"/> Marks/Chatter<br><input type="checkbox"/> Turning Sequence<br><input type="checkbox"/> Wave/Twist in Tube | <b>General</b><br><input type="checkbox"/> Bend<br><input type="checkbox"/> BOM/Route<br><input type="checkbox"/> Broken/Damage/Defect<br><input type="checkbox"/> Burrs<br><input type="checkbox"/> Contamination<br><input type="checkbox"/> Countersink<br><input type="checkbox"/> Cut Too Short<br><input type="checkbox"/> Drawing<br><input type="checkbox"/> Drill Holes<br><input type="checkbox"/> Finish<br><input type="checkbox"/> Fit/Function | <input type="checkbox"/> Folio/Program<br><input type="checkbox"/> Grain<br><input type="checkbox"/> Hardware<br><input type="checkbox"/> Inspection Incomplete/Unqualified<br><input type="checkbox"/> Instructions Incomplete/Unclear<br><input type="checkbox"/> Misaligned/off center<br><input type="checkbox"/> Mislabeled<br><input type="checkbox"/> Misread<br><input type="checkbox"/> Off-set<br><input type="checkbox"/> Out of Calibration<br><input type="checkbox"/> Out of Sequence | <input type="checkbox"/> Outside Dimensions<br><input type="checkbox"/> Over/Under tolerance<br><input type="checkbox"/> Part Incorrect<br><input type="checkbox"/> Part Lost/Missing<br><input type="checkbox"/> Part Moved<br><input type="checkbox"/> Positioned Wrong<br><input type="checkbox"/> Power Loss/Surge<br><br><input type="checkbox"/> Pressure/Forced<br><input type="checkbox"/> Set-up<br><input type="checkbox"/> Temperature/Cure<br><input type="checkbox"/> Weld<br><input type="checkbox"/> Wrong Stock Pulled<br><br><input type="checkbox"/> Other |
|---|---|---|---|

Work Order ID 129276

\*129276\*

Page 2

Friday, January 30, 2015 2:02:03 PM

Item ID: D3183-5 Accept \*N900040100\* Setup Start \*NS1\*

Revision ID: Stop \*NS2\*

Item Name: Bearing

Start Date: 1/30/15 Start Qty: 100.00 \*100\* Cust Item ID:

Required Date: 2/02/15 Req'd Qty: 100.00 \*100\* Customer:

Reference:

Approvals: Process Plan: \_\_\_\_\_ Date: \_\_\_\_\_ Tooling: \_\_\_\_\_ Date: \_\_\_\_\_ Run Start \*NR1\*

QC: \_\_\_\_\_ Date: \_\_\_\_\_ SPC (Y/N): \_\_\_\_\_ Date: \_\_\_\_\_ Stop \*NR2\*

| Sequence ID/<br>Work Center ID | Operation<br>Description                           | Set Up/<br>Run Hours | Tool ID | Tool # | Plan<br>Code | Accept<br>Qty | Reject<br>Qty | Reject<br>Number | Insp.<br>Stamp |
|--------------------------------|----------------------------------------------------|----------------------|---------|--------|--------------|---------------|---------------|------------------|----------------|
| 130                            | Identify as per dwg & Stock Location: <u>81024</u> | 0.00                 |         |        |              |               |               |                  |                |
| *130*                          |                                                    |                      |         |        |              |               |               |                  |                |
| Packaging                      | Memo                                               | 0.00                 |         |        |              |               |               |                  |                |
| Packaging                      |                                                    |                      |         |        |              |               |               |                  |                |
| 140                            | QC21- Final Inspection - Work Order Release        | 0.00                 |         |        |              |               |               |                  |                |
| *140*                          |                                                    |                      |         |        |              |               |               |                  |                |
| QC                             | Memo                                               | 0.00                 |         |        |              |               |               |                  |                |
| Quality Control                |                                                    |                      |         |        |              |               |               |                  |                |

160 X 815-02-3

MLD 15-02-03

AB-2-3

DQA: \_\_\_\_\_ Date: \_\_\_\_\_



## WORK ORDER NON-CONFORMANCE / UPDATE

QA Closed: \_\_\_\_\_ Date: \_\_\_\_\_

Work Order update only ☐

|                                                              |   |   |                                      |                                    |                                    |                                      |                                    |                                    |                                            |                                  |                                        |                                    |                                              |                                |                                    |                                    |                                   |  |
|--------------------------------------------------------------|---|---|--------------------------------------|------------------------------------|------------------------------------|--------------------------------------|------------------------------------|------------------------------------|--------------------------------------------|----------------------------------|----------------------------------------|------------------------------------|----------------------------------------------|--------------------------------|------------------------------------|------------------------------------|-----------------------------------|--|
| Work Order: _____<br><br>Part No. _____<br><br>NCR No. _____ | <b>DISPOSITION</b><br><br>Rework <input type="checkbox"/><br>Scrap <input type="checkbox"/><br>Use-as-is <input type="checkbox"/><br>Suspected Unapproved <input type="checkbox"/> | <b>AGAINST DEPARTMENT/PROCESS</b><br><br><table style="width: 100%;"> <tr> <td>Skid-tube <input type="checkbox"/></td> <td>Crosstube <input type="checkbox"/></td> <td>Water Jet <input type="checkbox"/></td> <td>Engineering <input type="checkbox"/></td> </tr> <tr> <td>Machining <input type="checkbox"/></td> <td>Small Fab <input type="checkbox"/></td> <td>Prod. Eng. Coord. <input type="checkbox"/></td> <td>Quality <input type="checkbox"/></td> </tr> <tr> <td>Thermoforming <input type="checkbox"/></td> <td>Finishing <input type="checkbox"/></td> <td>Rec/Store/Packaging <input type="checkbox"/></td> <td>Other <input type="checkbox"/></td> </tr> <tr> <td>Large Fab <input type="checkbox"/></td> <td>Composite <input type="checkbox"/></td> <td>Supplier <input type="checkbox"/></td> <td></td> </tr>





| Root Cause    | Date | Step | Qty | Description of work order update or non-conformance | Initial Chief Eng | Action Description | Sign & Date | Verification | QC Inspector |
|---------------|------|------|-----|-----------------------------------------------------|-------------------|--------------------|-------------|--------------|--------------|
| Design        |      |      |     |                                                     |                   |                    |             |              |              |
| Doc/Data      |      |      |     |                                                     |                   |                    |             |              |              |
| Equip/Tooling |      |      |     |                                                     |                   |                    |             |              |              |
| Handling/Pre  |      |      |     |                                                     |                   |                    |             |              |              |
| Material      |      |      |     |                                                     |                   |                    |             |              |              |
| Operator      |      |      |     |                                                     |                   |                    |             |              |              |
| Offset/Setup  |      |      |     |                                                     |                   |                    |             |              |              |
| Process       |      |      |     |                                                     |                   |                    |             |              |              |
| Supplier      |      |      |     |                                                     |                   |                    |             |              |              |
| Training      |      |      |     |                                                     |                   |                    |             |              |              |
| Transport     |      |      |     |                                                     |                   |                    |             |              |              |
| Unapproved    |      |      |     |                                                     |                   |                    |             |              |              |

### FAULT CATEGORY

|   |   |   |   |
|---|---|---|---|
| <b>Landing Gear</b><br><input type="checkbox"/> Bending<br><input type="checkbox"/> Centre Not Concentric<br><input type="checkbox"/> Cracks<br><input type="checkbox"/> Crimp/Kink/Ripple/Wave<br><input type="checkbox"/> Cuffs<br><input type="checkbox"/> Crushing<br><input type="checkbox"/> Heat Treat<br><input type="checkbox"/> Inspection Strip in Tube<br><input type="checkbox"/> Marks/Chatter<br><input type="checkbox"/> Turning Sequence<br><input type="checkbox"/> Wave/Twist in Tube | <b>General</b><br><input type="checkbox"/> Bend<br><input type="checkbox"/> BOM/Route<br><input type="checkbox"/> Broken/Damage/Defect<br><input type="checkbox"/> Burrs<br><input type="checkbox"/> Contamination<br><input type="checkbox"/> Countersink<br><input type="checkbox"/> Cut Too Short<br><input type="checkbox"/> Drawing<br><input type="checkbox"/> Drill Holes<br><input type="checkbox"/> Finish<br><input type="checkbox"/> Fit/Function | <input type="checkbox"/> Folio/Program<br><input type="checkbox"/> Grain<br><input type="checkbox"/> Hardware<br><input type="checkbox"/> Inspection Incomplete/Unqualified<br><input type="checkbox"/> Instructions Incomplete/Unclear<br><input type="checkbox"/> Misaligned/off center<br><input type="checkbox"/> Mislabeled<br><input type="checkbox"/> Misread<br><input type="checkbox"/> Off-set<br><input type="checkbox"/> Out of Calibration<br><input type="checkbox"/> Out of Sequence | <input type="checkbox"/> Outside Dimensions<br><input type="checkbox"/> Over/Under tolerance<br><input type="checkbox"/> Part Incorrect<br><input type="checkbox"/> Part Lost/Missing<br><input type="checkbox"/> Part Moved<br><input type="checkbox"/> Positioned Wrong<br><input type="checkbox"/> Power Loss/Surge<br><br><input type="checkbox"/> Pressure/Forced<br><input type="checkbox"/> Set-up<br><input type="checkbox"/> Temperature/Cure<br><input type="checkbox"/> Weld<br><input type="checkbox"/> Wrong Stock Pulled<br><br><input type="checkbox"/> Other |
|---|---|---|---|

# Picklist Print

Friday, January 30, 2015 2:02:07 PM

Page 1

Work Order ID: 129276

\*129276\*

Parent Item: D3183-5

\*D3183-5\*

Parent Item Name: Bearing

Start Date: 1/30/15

Required Date: 2/02/15

Start Qty: 100.00

Required Qty: 100.00

Comments: IPP: A03.03.27New issueKJ/RF

| Component Item ID/<br>Item Name | Replacement<br>Item ID | Mfg/<br>Purch | Bin<br>Item | Primary<br>Location | Last<br>Location | Route<br>Seq ID | Unit of<br>Measure | Qty on<br>Hand | Qty per Kit | Total<br>Qty | Qty<br>Issued | Date<br>Issued | Status |
|---------------------------------|------------------------|---------------|-------------|---------------------|------------------|-----------------|--------------------|----------------|-------------|--------------|---------------|----------------|--------|
|---------------------------------|------------------------|---------------|-------------|---------------------|------------------|-----------------|--------------------|----------------|-------------|--------------|---------------|----------------|--------|

6800ZZ

Purchased

No

100

Each

0.0000

1

100

\*680077\*

\*\*

Bearing

100x SP15-02-2.

DQA: \_\_\_\_\_ Date: \_\_\_\_\_



## WORK ORDER NON-CONFORMANCE / UPDATE

QA Closed: \_\_\_\_\_ Date: \_\_\_\_\_

Work Order update only ☐

|                                                              |   |   |
|--------------------------------------------------------------|---|---|
| Work Order: _____<br><br>Part No. _____<br><br>NCR No. _____ | <b>DISPOSITION</b><br><br>Rework <input type="checkbox"/><br>Scrap <input type="checkbox"/><br>Use-as-is <input type="checkbox"/><br>Suspected Unapproved <input type="checkbox"/> | <b>AGAINST DEPARTMENT/PROCESS</b><br><br><div style="display: flex; justify-content: space-between;"> <div>           Skid-tube <input type="checkbox"/><br/>           Machining <input type="checkbox"/><br/>           Thermoforming <input type="checkbox"/><br/>           Large Fab <input type="checkbox"/> </div> <div>           Crosstube <input type="checkbox"/><br/>           Small Fab <input type="checkbox"/><br/>           Finishing <input type="checkbox"/><br/>           Composite <input type="checkbox"/> </div> <div>           Water Jet <input type="checkbox"/><br/>           Prod. Eng. Coord. <input type="checkbox"/><br/>           Rec/Store/Packaging <input type="checkbox"/><br/>           Supplier <input type="checkbox"/> </div> <div>           Engineering <input type="checkbox"/><br/>           Quality <input type="checkbox"/><br/>           Other <input type="checkbox"/> </div> </div> |
|--------------------------------------------------------------|---|---|

| Root Cause    | Date | Step | Qty | Description of work order update or non-conformance | Initial Chief Eng | Action Description | Sign & Date | Verification | QC Inspector |
|---------------|------|------|-----|-----------------------------------------------------|-------------------|--------------------|-------------|--------------|--------------|
| Design        |      |      |     |                                                     |                   |                    |             |              |              |
| Doc/Data      |      |      |     |                                                     |                   |                    |             |              |              |
| Equip/Tooling |      |      |     |                                                     |                   |                    |             |              |              |
| Handling/Pre  |      |      |     |                                                     |                   |                    |             |              |              |
| Material      |      |      |     |                                                     |                   |                    |             |              |              |
| Operator      |      |      |     |                                                     |                   |                    |             |              |              |
| Offset/Setup  |      |      |     |                                                     |                   |                    |             |              |              |
| Process       |      |      |     |                                                     |                   |                    |             |              |              |
| Supplier      |      |      |     |                                                     |                   |                    |             |              |              |
| Training      |      |      |     |                                                     |                   |                    |             |              |              |
| Transport     |      |      |     |                                                     |                   |                    |             |              |              |
| Unapproved    |      |      |     |                                                     |                   |                    |             |              |              |


### FAULT CATEGORY

|   |   |   |   |
|---|---|---|---|
| <b>Landing Gear</b><br><input type="checkbox"/> Bending<br><input type="checkbox"/> Centre Not Concentric<br><input type="checkbox"/> Cracks<br><input type="checkbox"/> Crimp/Kink/Ripple/Wave<br><input type="checkbox"/> Cuffs<br><input type="checkbox"/> Crushing<br><input type="checkbox"/> Heat Treat<br><input type="checkbox"/> Inspection Strip in Tube<br><input type="checkbox"/> Marks/Chatter<br><input type="checkbox"/> Turning Sequence<br><input type="checkbox"/> Wave/Twist in Tube | <b>General</b><br><input type="checkbox"/> Bend<br><input type="checkbox"/> BOM/Route<br><input type="checkbox"/> Broken/Damage/Defect<br><input type="checkbox"/> Burrs<br><input type="checkbox"/> Contamination<br><input type="checkbox"/> Countersink<br><input type="checkbox"/> Cut Too Short<br><input type="checkbox"/> Drawing<br><input type="checkbox"/> Drill Holes<br><input type="checkbox"/> Finish<br><input type="checkbox"/> Fit/Function | <input type="checkbox"/> Folio/Program<br><input type="checkbox"/> Grain<br><input type="checkbox"/> Hardware<br><input type="checkbox"/> Inspection Incomplete/Unqualified<br><input type="checkbox"/> Instructions Incomplete/Unclear<br><input type="checkbox"/> Misaligned/off center<br><input type="checkbox"/> Mislabeled<br><input type="checkbox"/> Misread<br><input type="checkbox"/> Off-set<br><input type="checkbox"/> Out of Calibration<br><input type="checkbox"/> Out of Sequence | <input type="checkbox"/> Outside Dimensions<br><input type="checkbox"/> Over/Under tolerance<br><input type="checkbox"/> Part Incorrect<br><input type="checkbox"/> Part Lost/Missing<br><input type="checkbox"/> Part Moved<br><input type="checkbox"/> Positioned Wrong<br><input type="checkbox"/> Power Loss/Surge<br><br><input type="checkbox"/> Pressure/Forced<br><input type="checkbox"/> Set-up<br><input type="checkbox"/> Temperature/Cure<br><input type="checkbox"/> Weld<br><input type="checkbox"/> Wrong Stock Pulled<br><br><input type="checkbox"/> Other |
|---|---|---|---|




|                         |                     |                                                          |                        |
|-------------------------|---------------------|----------------------------------------------------------|------------------------|
| DESIGN<br>#             | DRAWN BY<br>UP      | <b>DART AEROSPACE LTD</b><br>HAWKESBURY, ONTARIO, CANADA |                        |
| CHECKED<br>#            | APPROVED<br>#       | DRAWING NO.<br><b>D3183</b>                              | REV. C<br>SHEET 1 OF 4 |
| DATE<br><b>04.02.17</b> |                     | TITLE<br><b>BRACKET ASSEMBLY</b>                         | SCALE<br>1:1           |
| A                       | 03.01.24            | NEW ISSUE                                                |                        |
| B                       | 03.06.17            | REMOVE BEARING; 1.012 WS 0.882                           |                        |
| C                       | 04.02.17            | ADD -045/-9; 0.182 WAS 0.431                             |                        |
| C1                      | <del>04.11.09</del> | <del>0.830 WAS 0.850</del>                               |                        |

RELEASED  
04.03.01  
DEO ATTACHED

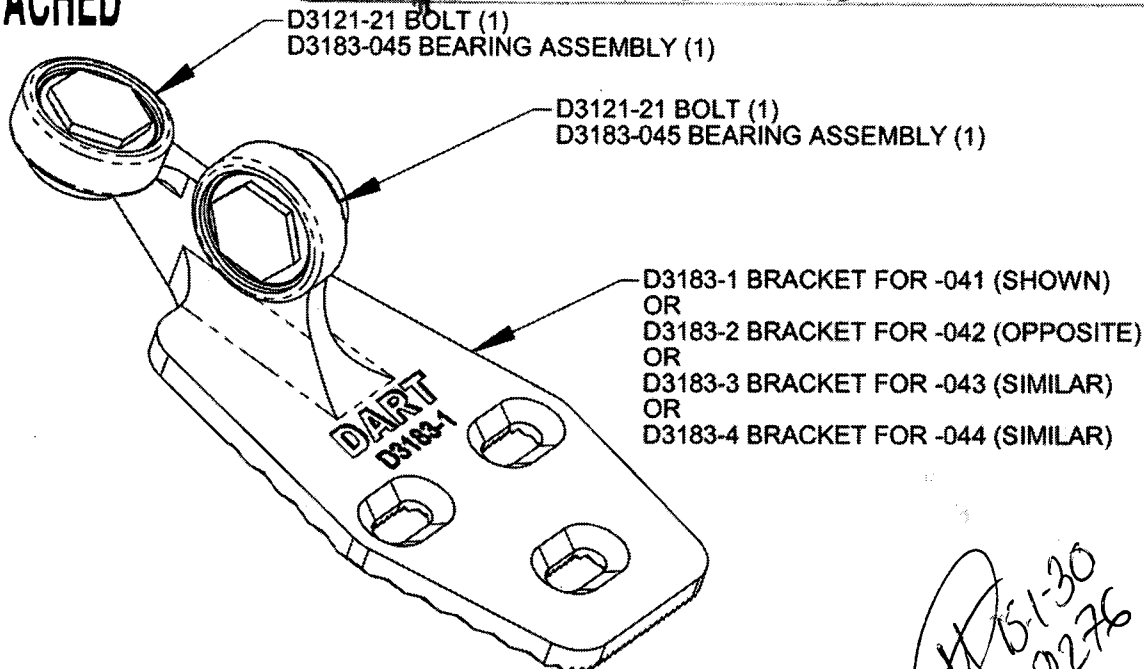


**D3183-041 BRACKET ASSEMBLY (SHOWN)**  
**D3183-042 BRACKET ASSEMBLY (OPPOSITE)**  
**D3183-043 BRACKET ASSEMBLY (SIMILAR)**  
**D3183-044 BRACKET ASSEMBLY (SIMILAR)**

151-30  
120276

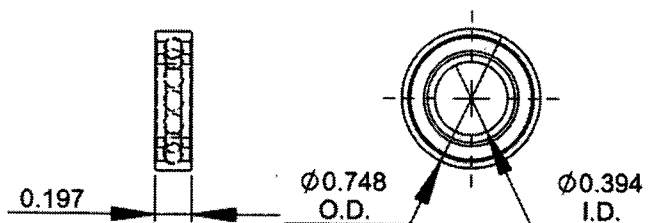

**D3183-5 BEARING:**  
**SPECIFICATION CONTROL DRAWING**

- 1) SINGLE ROW, DEEP GROOVE, CONRAD TYPE, SHIELDED
- 2) POSSIBLE SUPPLIER: NSK P/N 6800ZZ
- 3) ALL DIMENSIONS ARE IN INCHES

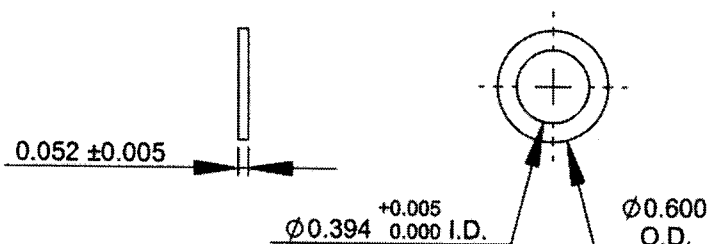

**D3183-7 WASHER**

- 1) MATERIAL: AISI 303 ROUND BAR (M303R) ANNEALED
- 2) BREAK ALL SHARP EDGES 0.005 TO 0.010
- 3) TOLERANCES ARE PER DART QSI 018 UNLESS OTHERWISE NOTED
- 4) ALL DIMENSIONS ARE IN INCHES

**COPYRIGHT © 2003 BY DART AEROSPACE LTD.**





THIS DOCUMENT IS PRIVATE AND CONFIDENTIAL AND IS SUPPLIED ON THE EXPRESS CONDITION THAT IT IS NOT TO BE USED FOR ANY PURPOSE OR COPIED OR COMMUNICATED TO ANY OTHER PERSON WITHOUT WRITTEN PERMISSION FROM DART AEROSPACE LTD.



|          |          |                                                   |              |
|----------|----------|---------------------------------------------------|--------------|
| DESIGN   | DRAWN BY | DART AEROSPACE LTD<br>HAWKESBURY, ONTARIO, CANADA |              |
| CHECKED  | APPROVED | DRAWING NO.                                       | REV. C       |
|          |          | D3183                                             | SHEET 2 OF 4 |
| DATE     |          | TITLE                                             | SCALE        |
| 04.02.17 |          | BRACKET ASSEMBLY                                  | 1:2          |

RELEASED  
04.03.01

DEO ATTACHED

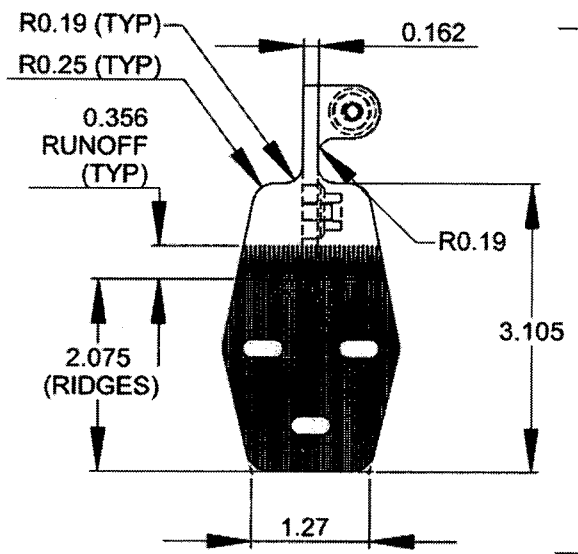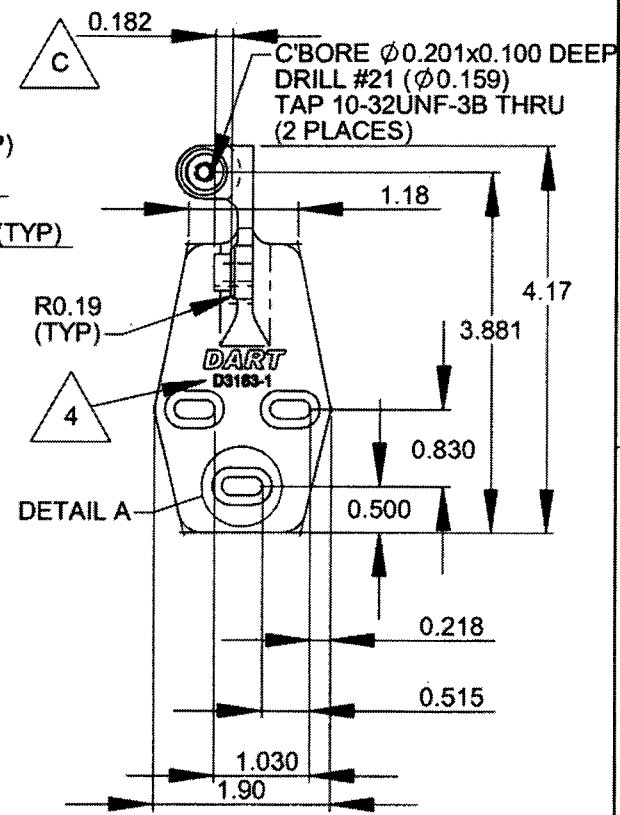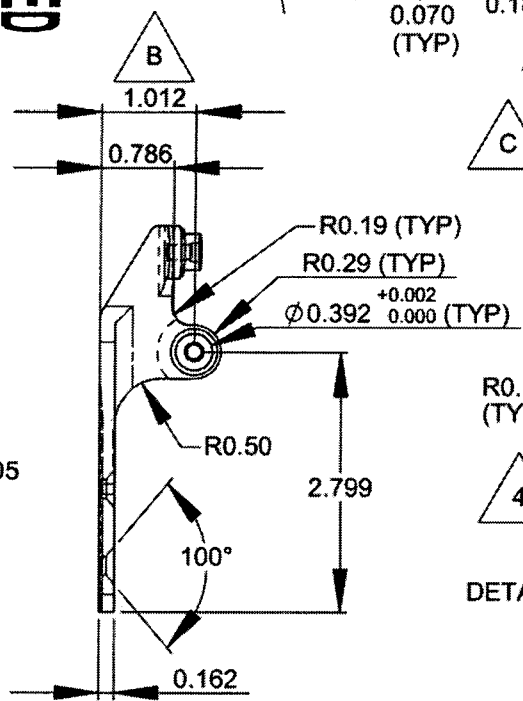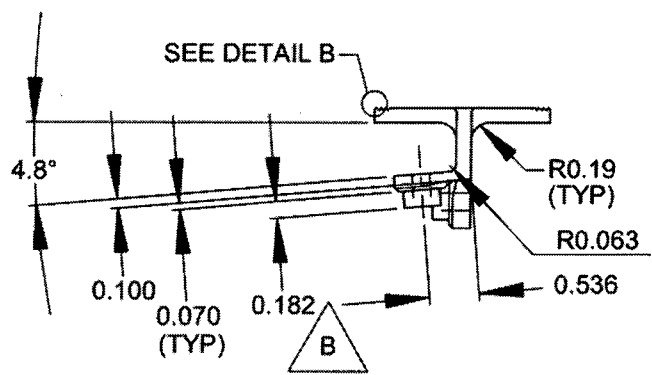

**D3183-1 BRACKET SHOWN  
D3183-2 BRACKET OPPOSITE**

- 1) D3183-1 CAN BE MADE FROM D3183-3  
D3183-2 CAN BE MADE FROM D3183-4
- 2) MATERIAL: 17-4 SS PER AMS 5604/5643  
(REF DART SPEC. M17-4-B)  
MIN ULTIMATE STRENGTH = 150 ksi  
MIN YIELD STRENGTH = 100 ksi
- 3) BREAK ALL SHARP EDGES 0.005 TO 0.015
- 4) ENGRAVE DART P/N & LOGO AS SHOWN
- 5) TOLERANCES ARE PER DART QSI 018 UNLESS OTHERWISE NOTED
- 6) ALL DIMENSIONS ARE IN INCHES


COPYRIGHT © 2003 BY DART AEROSPACE LTD.

THIS DOCUMENT IS PRIVATE AND CONFIDENTIAL AND IS SUPPLIED ON THE EXPRESS CONDITION THAT IT IS NOT TO BE USED FOR ANY PURPOSE OR COPIED OR COMMUNICATED TO ANY OTHER PERSON WITHOUT WRITTEN PERMISSION FROM DART AEROSPACE LTD.



QACORP  
ISSUED

|   |   |   |  |                                                          |  |
|---|---|---|--|----------------------------------------------------------|--|
| <b>DESIGN</b><br>  |   | <b>DRAWN BY</b><br> |  | <b>DART AEROSPACE LTD</b><br>HAWKESBURY, ONTARIO, CANADA |  |
| <b>CHECKED</b><br> | <b>APPROVED</b><br> | <b>DRAWING NO.</b><br>D3183                                                                            |  | <b>REV. C</b><br>SHEET 3 OF 4                            |  |
| <b>DATE</b><br>04.02.17                                                                               |   | <b>TITLE</b><br>BRACKET ASSEMBLY                                                                       |  | <b>SCALE</b><br>1:2                                      |  |

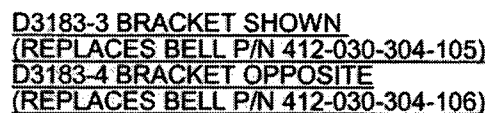


- 1) MATERIAL: 17-4 SS PER AMS 5604/5643  
(REF DART SPEC. M17-4-B)  
MIN ULTIMATE STRENGTH = 150 ksi  
MIN YIELD STRENGTH = 100 ksi
- 2) BREAK ALL SHARP EDGES 0.005 TO 0.015
- 3) ENGRAVE DART P/N & LOGO AS SHOWN
- 4) TOLERANCES ARE PER DART QSI 018 UNLESS OTHERWISE NOTED
- 5) ALL DIMENSIONS ARE IN INCHES

**COPYRIGHT © 2003 BY DART AEROSPACE LTD**

THIS DOCUMENT IS PRIVATE AND CONFIDENTIAL AND IS SUPPLIED ON THE EXPRESS CONDITION THAT IT IS NOT TO BE USED FOR ANY PURPOSE OR COPIED OR COMMUNICATED TO ANY OTHER PERSON WITHOUT WRITTEN PERMISSION FROM DART AEROSPACE LTD.




|                               |                                |                                                          |                        |
|-------------------------------|--------------------------------|----------------------------------------------------------|------------------------|
| DESIGN<br><i>[Signature]</i>  | DRAWN BY<br><i>[Signature]</i> | <b>DART AEROSPACE LTD</b><br>HAWKESBURY, ONTARIO, CANADA |                        |
| CHECKED<br><i>[Signature]</i> | APPROVED<br><i>[Signature]</i> | DRAWING NO.<br><b>D3183</b>                              | REV. C<br>SHEET 4 OF 4 |
| DATE<br><b>04.02.17</b>       |                                | TITLE<br><b>BRACKET ASSEMBLY</b>                         | SCALE<br>1:1           |

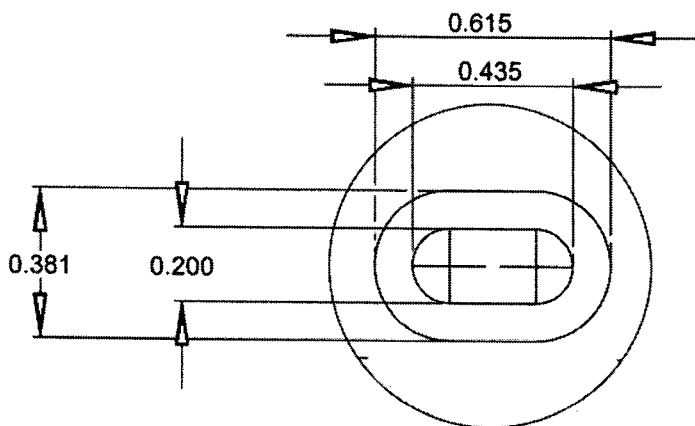


**DETAIL A (2 : 1)**

**RELEASED**  
04.03.01

**DEO ATTACHED**

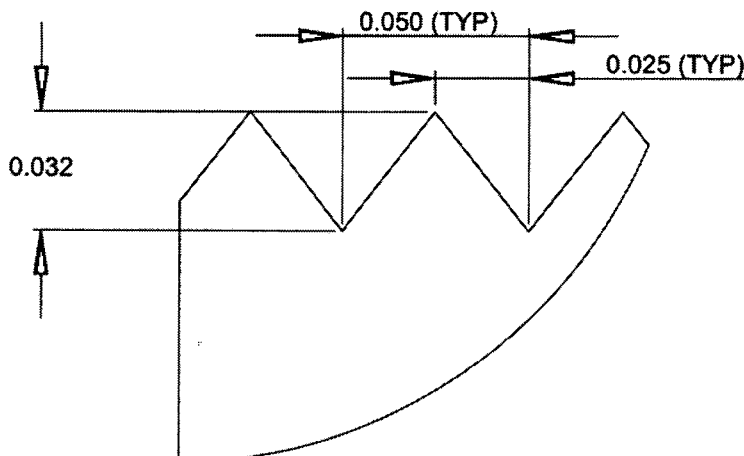

**DETAIL B (20 : 1)**

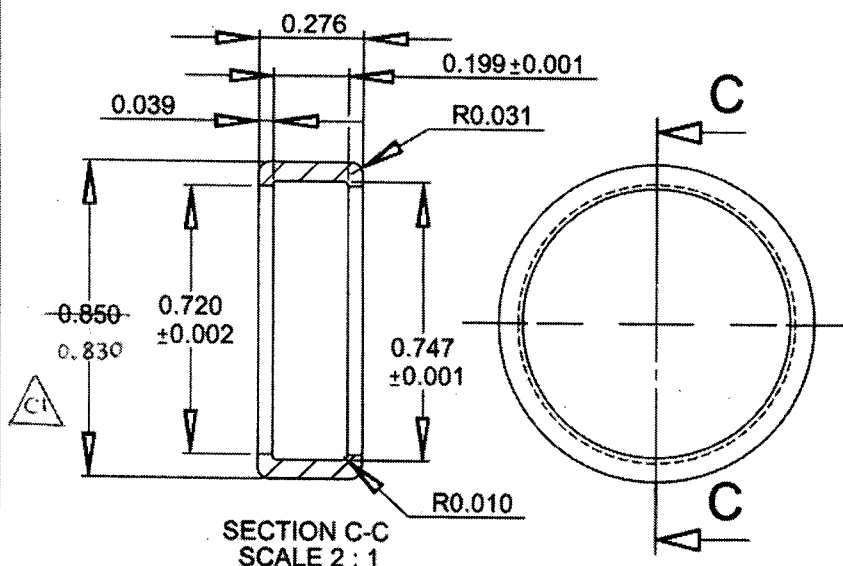

**D3183-9 CAP**

- 1) MATERIAL: DELRIN ROD, Ø1.00  
(REF DART SPEC. M-DELRIN-R1.00)
- 2) TOLERANCES ARE PER DART QSI 018  
UNLESS OTHERWISE NOTED
- 3) ALL DIMENSIONS ARE IN INCHES

**D3183-045 BEARING ASSEMBLY**

- 1) ASSEMBLE D3183-5 BEARING AND  
D3183-9 CAP

**COPYRIGHT © 2003 BY DART AEROSPACE LTD.**

THIS DOCUMENT IS PRIVATE AND CONFIDENTIAL AND IS SUPPLIED ON THE EXPRESS CONDITION THAT IT IS NOT TO BE USED FOR ANY PURPOSE OR COPIED OR COMMUNICATED TO ANY OTHER PERSON WITHOUT WRITTEN PERMISSION FROM DART AEROSPACE LTD.





Dart Aerospace Ltd.  
1270 Aberdeen Street  
Hawkesbury, ON K6A 1K7  
Tel: 613 632 9577  
Fax: 613 632 1053

## PURCHASE ORDER

Purchase Order ID **PO27293**

Purchase Order Date 1/30/2015

PO Print Date 1/30/2015

Page Number 1 of 2

**Order From :**

VC-MAI001

**Ship To :** DART AEROSPACE LTD

MAIN INDUSTRIAL SALES LTD.  
1475, TESSIER  
HAWKESBURY, ON K6A 3S6  
CA

1270 ABERDEEN  
HAWKESBURY, ON K6A 1K7  
CANADA

**Contact Name**

**Vendor Phone** 613 632 3595

**Ship To Contact**

**Ship To Phone**

**Ship Via:** Yours ppd

**Ship Acct:**

**Buyer**

Chantal Lavoie

**Customer POID**

**Customer Tax #**

10127-2607

**Terms**

Net 30

**Currency**

CAD

**FOB**

FCA - (Free Carrier)

| Line Nbr | Reference<br>Vendor Part Number<br>Line Comments<br>Delivery Comments | Description/<br>Mfg ID | Req Date/<br>Taxable<br>Promise Date | CD | Req Qty/<br>Unit of<br>Measure | PO Unit Price | Extended<br>Price |
|----------|-----------------------------------------------------------------------|------------------------|--------------------------------------|----|--------------------------------|---------------|-------------------|
| 1        | 6900ZZ                                                                | Bearing                | 2/2/2015<br>Yes<br>2/2/2015          |    | 100.00<br>Each                 | \$1.62        | \$162.00          |

AS PER DWG D3121 REV. E  
B128905

**Line Total:** \$162.00

|   |        |         |                             |  |                |        |          |
|---|--------|---------|-----------------------------|--|----------------|--------|----------|
| 2 | 6800ZZ | Bearing | 2/2/2015<br>Yes<br>2/2/2015 |  | 100.00<br>Each | \$1.48 | \$148.00 |
|---|--------|---------|-----------------------------|--|----------------|--------|----------|

AS PER DWG D3183 REV. C  
B129276

**Line Total:** \$148.00

Note:

1/30/2015

# MAIN INDUSTRIAL SALES LTD.

1475 TESSIER ST.  
HAWKESBURY ON K6A 3S6  
Phone: (613) 632-3595 Ext. Fax: (613) 632-0262  
sales@mainindustrialsales.com

# Packing Slip

DATE January 30, 2015  
NUMBER 0000178555  
CUSTOMER NO. DART

**BILL TO:**

DART AEROSPACE LTD.  
1270 ABERDEEN ST.  
HAWKESBURY ON K6A 1K7

**SHIP TO:**

DART AEROSPACE LTD.  
1270 ABERDEEN ST.  
HAWKESBURY ON K6A 1K7

(613) 632-5200 Ext.

(613) 632-5200 Ext.

| P.O. NUMBER                                            | SALESPERSON       | ORDER DATE  | REQ. DATE | ORDER NUMBER |
|--------------------------------------------------------|-------------------|-------------|-----------|--------------|
| 27293                                                  | EB                | 30-Jan-15   |           | 0000178555   |
| F.O.B.                                                 | SHIP VIA          | TERMS       |           |              |
| F.O.B. value                                           | OUR TRUCK / LOCAL | NET 30 DAYS |           |              |
| PART NUMBER                                            | LOCATION          | UOM         | QUANTITY  |              |
| DESCRIPTION                                            |                   |             | REQ.      | SHIPPED B.O. |
| 0-69002ZKML<br>KML BALL BEARING<br>YOUR PART #: 6900ZZ | 6D6               | EA          | 100       | 100          |
| 0-68002ZKML<br>BALL BEARING<br>YOUR PART #: 6800ZZ     | 6D6               | EA          | 100       | 100 ✓        |

8015-02-

CERTIFICATE OF COMPLIANCE

RE: 6800-ZZ BEARING

To Whom It May Concern:

Our bearing rings and balls are made of high carbon chromium steel GCr15 which has a chemical composition equivalent to SAE 52100. The hardness of bearing rings is HRC 59-64 and HRC 60-65 for steel balls. Unless specify, bearings are 25-30% filled with Alvania No. 2 grease or Chevron SRI#2 grease or equivalent.

Stella Fan

Phone: 905-629-4255

Fax: 905-629-2358

The logo for SMART SUPPLIES features the word "SMART" in a bold, sans-serif font above the word "SUPPLIES" in a similar font. Above the letter "A" in "SMART", there are three curved lines of varying lengths, resembling a stylized fan or a signal antenna.

**SMART**  
**SUPPLIES**